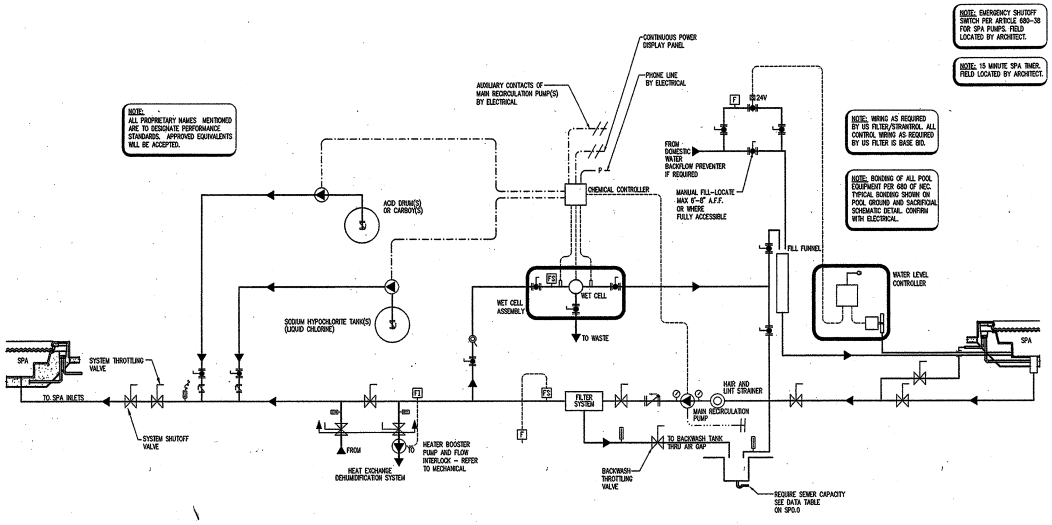

1 SP6.1 SPA SYSTEMS SCHEMATIC

NTS 05/15/04

LEGEND

- ELECTRICAL LINE
- WATER LINE
- AIR LINE
- 1 PHASE POWER
- 3 PHASE POWER
- P PHONE LINE

SYMBOL LEGEND

- BUTTERFLY VALVE
- CHECK VALVE
- PRESSURE/VACUUM/COMPOUND GAUGE
- BALL VALVE
- IMPACT FLOW METER
- THERMOMETER
- SOLENOID VALVE
- VENTURI
- POWER CORD
- HAIR AND LINT STRAINER
- FLOW SENSOR
- FLOW METER
- FLOW INTERLOCK
- PUMP
- PRESSURE GAUGE
- MODULATING FLOAT VALVE
- STRAINER
- DIGITAL TEMP SENSOR

WISNEWSKI BLAIR & ASSOCIATES, Ltd
44 Canal Center Plaza
Suite 200
Alexandria, VA 22314
P 703.836.0400
F 703.836.0942
www.blair-wba.com

MOODY NOLAN INC.
Architecture • Engineering • Planning • Interior Design
300 Spruce Street
Columbus, Ohio 43215
Phone: (614) 461-4664
Fax: (614) 224-6253
Columbus@MoodyNolan.com
www.moodynolan.com

COUNSELMAN/HUNSAKER & ASSOC.
9000 BELLWOOD ROAD, SUITE 400
FAIRFAX, VA 22031
PHONE: (703) 698-0700 FAX: (703) 698-0709

COMMONWEALTH OF VIRGINIA
SCOTT WADE HEBRTER
No. 0402.029006
PROFESSIONAL ENGINEER

Sed

PRCS

CLAUDE MOORE RECREATION CENTER

FROGSHACKEL WAY, CLUADE MOORE PARK
STERLING, VIRGINIA

POOL SYSTEMS SCHEMATIC

LOUDOUN COUNTY VIRGINIA

No.	DATE	DESCRIPTION
	07/28/04	100% BID DOCUMENTS

AS BUILT

SCALE:	AS INDICATED
DRAWN BY:	MEM
CHECKED BY:	SWH
WBA REF. No.	

SP6.1

Sheet Number

© 2004 Counselman/Hunsaker & Associates, Inc.