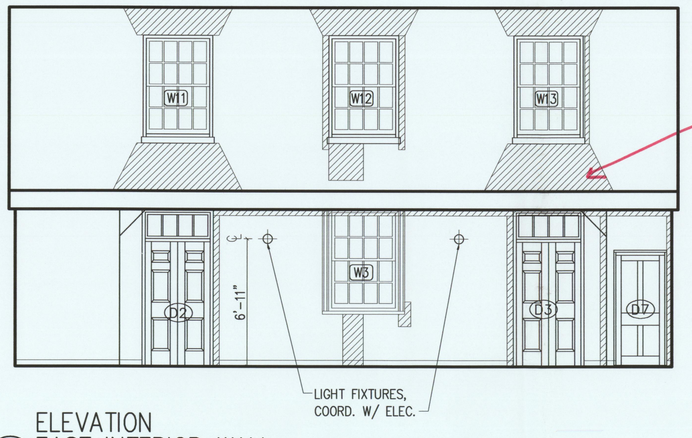

1 A-3 ELEVATION EAST INTERIOR WALL 1/4"=1'-0"

SPEC 09200

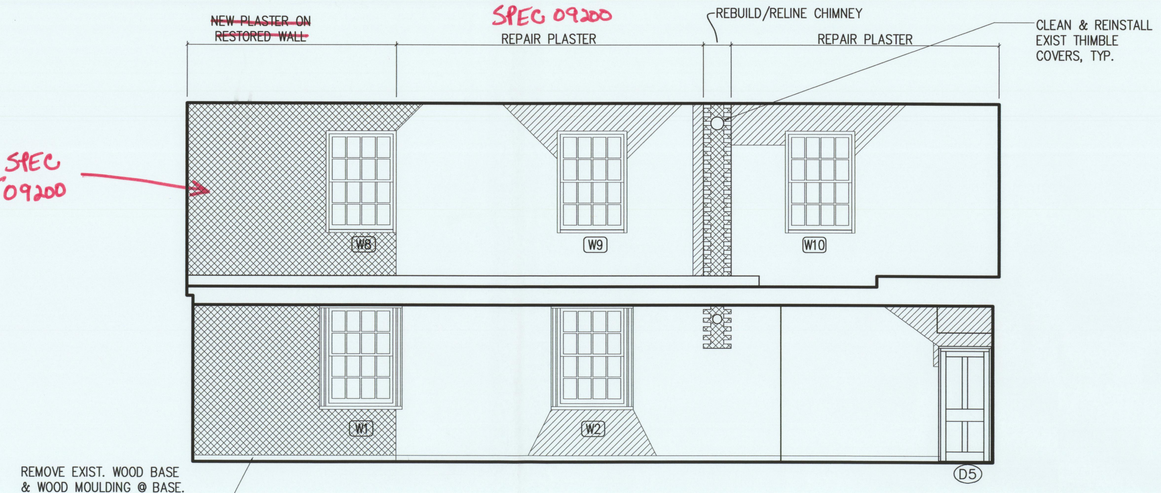

2 A-3 ELEVATION NORTH INTERIOR WALL 1/4"=1'-0"

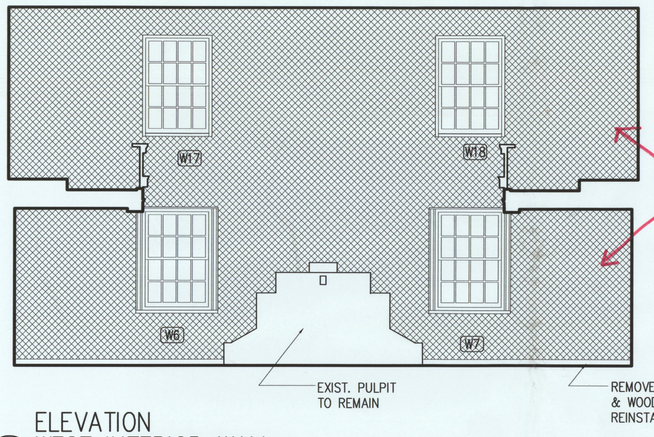

SPEC 09200

3 A-3 ELEVATION WEST INTERIOR WALL 1/4"=1'-0"

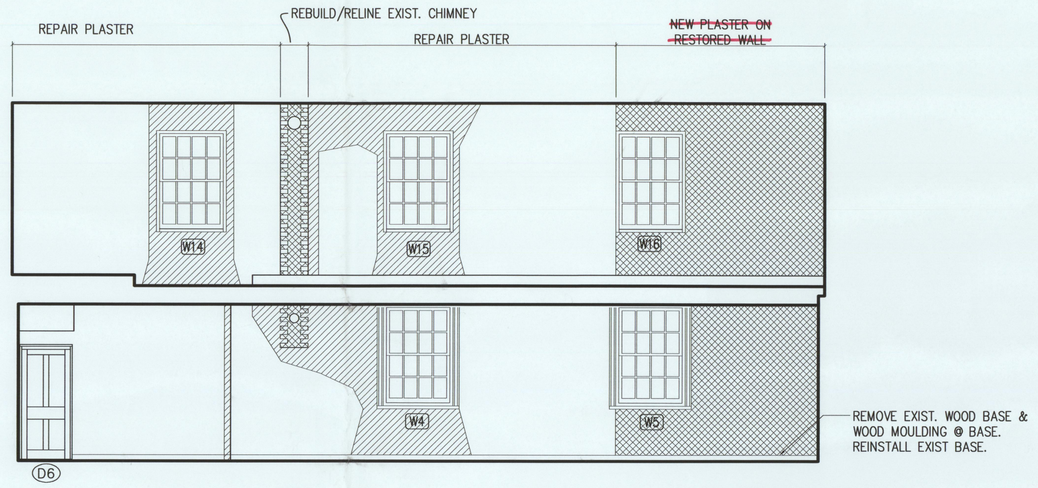

4 A-3 ELEVATION SOUTH INTERIOR WALL 1/4"=1'-0"

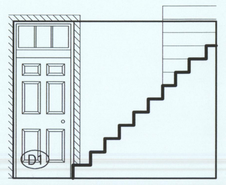

5 A-3 N. STAIR ELEVATION NORTH WALL 1/4"=1'-0"

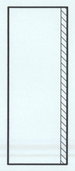

6 A-3 N. STAIR ELEVATION WEST WALL 1/4"=1'-0"

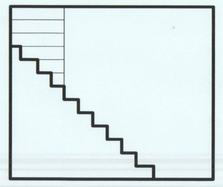

NOTE:
ASSUME APPROXIMATELY 10sf± OF PLASTER ~~TO REMOVE & REPLACE~~ INSIDE N. STAIRWELL

SPEC 09200

7 A-3 N. STAIR ELEVATION SOUTH WALL 1/4"=1'-0"

REMOVE EXIST THROUGH-WALL ANCHOR & PATCH HOLE.

~~REMOVE EXIST DAMAGED INT. BRICK & REPLACE W/ NEW BRICK TO MATCH EXIST SOUND INT. BRICK IN SIZE & HARDNESS. PROVIDE SOFT LIME MORTAR TO MATCH EXIST SOUND INT. MORTAR. EXIST EXT. BRICK TO REMAIN.~~

13 A-3 INTERIOR OF EAST GABLE IN ATTIC NO SCALE

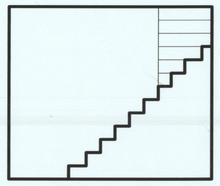

8 A-3 S. STAIR ELEVATION NORTH WALL 1/4"=1'-0"

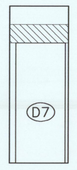

9 A-3 S. STAIR ELEVATION WEST WALL 1/4"=1'-0"

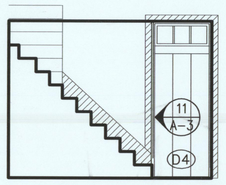

NOTE:
ASSUME APPROXIMATELY 16sf± OF PLASTER ~~TO REMOVE & REPLACE~~ INSIDE S. STAIRWELL

SPEC 09200

10 A-3 S. STAIR ELEVATION SOUTH WALL 1/4"=1'-0"

REMOVE ONE EXIST DAMAGED RISER & TWO DAMAGED TREADS & REPLACE W/ NEW TO PRECISELY MATCH EXIST IN THICKNESS, PROFILE, SPECIES, FINISH, & FASTENING METHODS

11 A-3 SOUTH STAIR NO SCALE

EXISTING COLUMNS, PULPIT, DOORS, BALCONY RAILINGS, FIRST & SECOND WOOD FLOORS, STAIRS, AND ALL OTHER WOOD SURFACES (EXCEPT PEWS) THROUGHOUT INTERIOR SHALL BE THOROUGHLY CLEANED PER SPECS.

12 A-3 INTERIOR WOOD FINISHES NO SCALE

GENERAL NOTES

A. IDENTIFY & REPLACE ALL AREAS OF LOOSE, CRACKED, OR UNSUITABLE WALL PLASTER IN ADDITION TO THOSE AREAS INDICATED. ASSUME 50 S.F. OF ADDITIONAL PLASTER REPLACEMENT. SPEC 09200

B. REMOVE ALL LOOSE PEELING PAINT ON EXIST PLASTER. PAINT ALL NEW & EXIST PLASTER AFTER NEW PLASTER HAS FULLY CURED (ONE YEAR). PRIOR TO PAINTING, REPAIR ALL CRACKS IN PLASTER RESULTING FROM CURING.

C. PLASTER REPAIRS AS INDICATED ARE APPROXIMATE. CONTRACTOR TO VERIFY IN FIELD. ALL "HOLLOW" OR "DEAD" PLASTER SHALL BE ~~REMOVED & REPLACED.~~ IAW SPEC 09200

D. REPAIR EXIST. CHIMNEYS AS FOLLOWS:

USE SAWSALL TO CUT MORTAR LINES OF BRICKS ON INTERIOR FACE OF CHIMNEY. REMOVE & SALVAGE BRICKS.
CLEAN FLUE OF ALL LOOSE DEBRIS.
RE-POINT FLUE AS NEEDED.
APPLY A PARGE COAT, SMOOTH FINISH SURFACE ON 2 SIDES & BACK.
WHERE CHIMNEY PASSES WOOD @ATTIC, 2 COAT PARGE WALL OF FLUE FACING WOOD MEMBERS. CONTINUE 2 COAT PARGING-1 ABOVE & 1 BELOW WOOD MEMBERS.
RE-USE OLD BRICKS WHERE POSSIBLE.
CLOSE INSIDE FLUE WALL. REBUILD CHIMNEY ABOVE ROOF.

LEGEND

~~NEW LIME PLASTER ON REBUILT WALL TO MATCH & ALIGN W/ EXIST. ASSUME 910 sf~~

REMOVE LOOSE OR UNSUITABLE PLASTER & REPLACE W/ NEW LIME TO MATCH & ALIGN W/ EXIST. ASSUME 300 sf

SPEC 09200

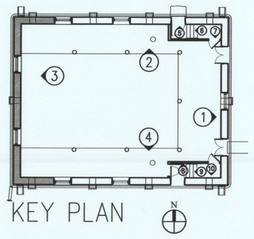

KEY PLAN

Samaha Associates P.C. architects

COMMONWEALTH OF VIRGINIA
SEMON S. SAMAHA
(LICENSE) No. 3941
ARCHITECT

9990 Lee Highway Suite 350 Fairfax, VA 22030
Phone 703-691-3311 Fax 703-691-3316

Douglass C. Reed
Historic Structures Consultants
P.O. Box 185
Smithsburg, MD 21783
1-301-730-2699
douglasscreed@myactv.net

Mount ZION Church Restoration

Loudoun County Department of Parks, Recreation, and Community Services

Virginia State project # 0000

Sheet Title:

INTERIOR ELEVATIONS

Drawing Number. – Of

A-3

Issue Date: 4/24/05

Drawn By: TRS
Checked By: RAM
Project Number: 1184000